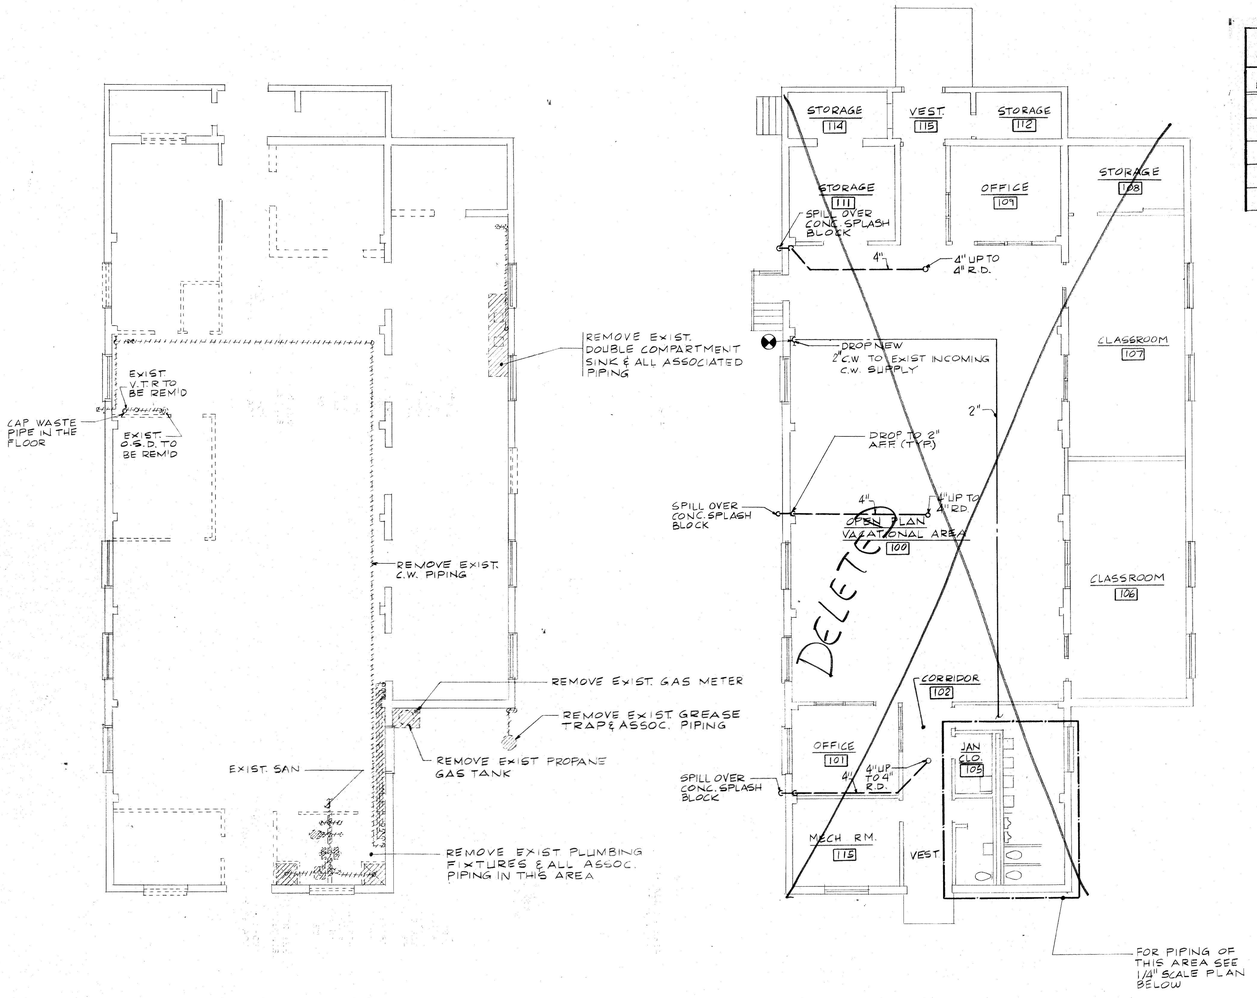

FLOOR PLAN - DEMOLITION
SCALE: 1/8" = 1'-0"

FLOOR PLAN - NEW WORK
SCALE: 1/8" = 1'-0"

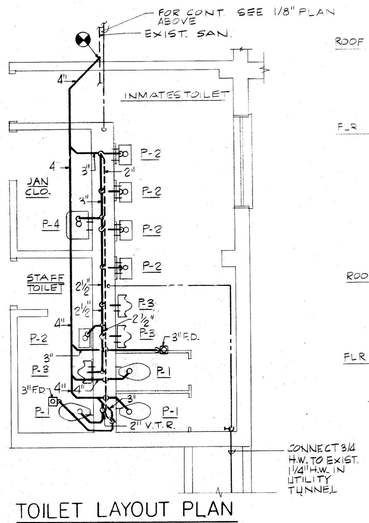

TOILET LAYOUT PLAN
SCALE: 1/4" = 1'-0"

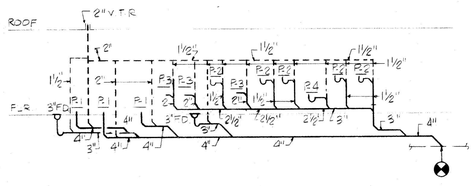

SANITARY RISER DIAGRAM
NO SCALE

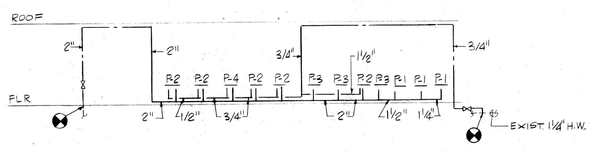

WATER RISER DIAGRAM
NO SCALE

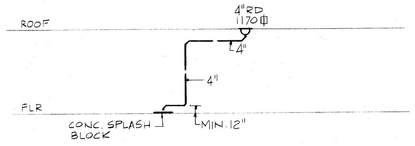

TYPICAL STORM RISER DIAGRAM
NO SCALE

PLUMBING FIXTURE CONNECTION SCHEDULE

MARK	FIXTURE	SAN.	V.P.	C.W.	H.W.	REMARKS
P-1	Water Closet	4"	2"	1"	-	Floor Mounted Flush Valve
P-2	Lavatory	1-1/2"	1-1/2"	1/2"	1/2"	Wall Hung
P-3	Urinal	2"	1-1/2"	3/4"	-	Wall Hung
P-4	Service Sink	3"	1-1/2"	1/2"	1/2"	"

SYMBOLS LIST

SYMBOL	ABBV	DEFINITION
	SAN.	SANITARY OR WASTE PIPE
	S.P.	STORM DRAIN PIPE
	V	VENT PIPE
	C.W.	COLD WATER PIPE
	H.W.	HOT WATER PIPE
		SHUT-OFF VALVE IN HORIZONTAL
		SHUT-OFF VALVE IN VERTICAL
		PIPE DOWN, PIPE UP
	F.D.	FLOOR DRAIN
	R.D.	ROOF DRAIN
		EXISTING PIPING TO BE REMOVED
		EXISTING SHUT-OFF VALVE IN HORIZONTAL TO BE REMOVED
		EXISTING SHUT-OFF VALVE IN VERTICAL TO BE REMOVED
		EXISTING FIXTURES TO BE REMOVED
	FLR.	FLOOR
	CLF.	CEILING
	V.T.R.	VENT THRU ROOF
		POINT OF CONNECTION NEW TO EXISTING
	A.F.F.	ABOVE FINISHED FLOOR
	O.S.D.	OPEN SIGHT DRAIN

As Built Dwg as of 12-14-84

DESIGNED
DRAWN
CHECKED
CERTIFICATION

REVISION | DATE | DESCRIPTION | BY | APP.

PROJECT DRAWINGS

LORTON IMPROVEMENTS - CENTRAL FACILITY
CIVIL ACTION
DEPARTMENT OF CORRECTIONS, LORTON, VA.

DRAWING NO. P-1

ASSISTANT DIRECTOR FOR BUREAU OF DESIGN AND ENGINEERING
DATE

REGISTRATION NO.
DATE
ARCHITECT
DATE

AUSTIN L. SPRIGGS ASSOCIATES
433 MASSACHUSETTS AVENUE, N.W., WASHINGTON, D.C. 20001
GOVERNMENT OF THE DISTRICT OF COLUMBIA
DEPARTMENT OF GENERAL SERVICES

PROJECT No. C-1011
DATE
SHEET ___ OF ___