INSTALLATION OF CELLS
BUILDING P-5 (PENITENTIARY)
LORTON, VIRGINIA

SCHEDULE OF DRAWINGS

ARCHITECTURAL

A-1	COVER SHEET
A-2	VICINITY MAP
A-3	SITE PLAN
A-4	PLANS · ELEVATIONS · SECTION
A-5	PLANS & SECTIONS
A-6	CELL DETAILS

STRUCTURAL

S-1	PLANS & DETAILS

PLUMBING

P-1	PLANS · DIAGRAMS · SCHEDULES · DETAILS

HEATING & VENTILATION

HV-1	PLANS · DIAGRAMS · SCHEDULES · DETAILS

ELECTRICAL

E-1	PLANS · DIAGRAMS · SCHEDULES · DETAILS

FINISH SCHEDULE	SHEET A-5
ROOM EQUIPMENT SCHEDULE	NONE
DOOR SCHEDULE	SHEET A-4
LINTEL SCHEDULE	SHEET S-1
PLUMBING FIXTURE SCHEDULE	SHEET P-1
PANEL SCHEDULE	SHEET E-1
LIGHTING FIXTURE SCHEDULE	SHEET E-1

ABBREVIATIONS

A.B	ANCHOR BOLT
A.T.C	ACOUSTICAL TILE CEILING
A.D	ACCESS DOOR
ADJ	ADJUSTABLE
A.I	AIR INTAKE
ALUM OR AL	ALUMINUM
ARCH	ARCHITECTURAL
APP	APPROVED
A.C.S	ARCH CAST STONE
B.S.C	BRICK SOLDIER COURSE
BM	BEAM
BLDG	BUILDING
B.B	BOND BEAM
BOT	BOTTOM
B.M	BENCH MARK
CLRM	CLASSROOM
C	COURSE
CAB	CABINET
CH.B	CHALKBOARD
C.C	COMBINATION CABINET
CEM	CEMENT
CER	CERAMIC
C.I	CAST IRON
C.J	CONSTRUCTION JOINT
℄	CENTER LINE
CLG	CEILING
CL. GL	CLEAR GLASS
CL. W GL	CLEAR WIRE GLASS
CL	CLOSET
C.M.U	CONC. MASONRY UNITS
C.L.	CHAIN LINK
C.O	CLEANOUT
COL	COLUMN
CONC	CONCRETE
CONT	CONTINUOUS
CONSTR	CONSTRUCTION
CONTR	CONTRACTOR
CONV	CONVECTOR
CORR	CORRIDOR
CORRUG	CORRUGATED
CONF	CONFERENCE
CUST DN	CUSTODIAN
DEPT	DEPARTMENT
DET	DETAIL
D.F	DRINKING FOUNTAIN
DIA OR ϕ	DIAMETER
DIM	DIMENSION
DN	DOWN
D.S	DOWNSPOUT
DWG	DRAWING
DR	DRAIN OR DOOR
DBL	DOUBLE
EA	EACH
E.W	EACH WAY
EL OR ELEV	ELEVATION
ELEC	ELECTRIC
EQ	EQUAL
EQUIP	EQUIPMENT
EXIST	EXISTING
EXP	EXPANSION
E.J	EXPANSION JOINT
E.J.S	EXPANSION JOINT STRIP
F	FINISH NUMBER
FD	FLOOR DRAIN
F.E.C	FIRE EXTINGUISHER CABINET
FIN	FINISHED
FIN FL	FINISHED FLOOR
FIN GR	FINISHED GRADE
FL	FLOOR
F.A	FRESH AIR
GA	GUAGE
GALV	GALVANIZED
G.I	GALVANIZED IRON
GL	GLASS
G.B	GRADE BEAM
GR	GRADE
G.C.M.U	GLAZED CONC. MAS UNITS
HWY	HIGHWAY
HGT	HEIGHT
H.M	HOLLOW METAL
HDW	HARDWARE
INSUL	INSULATION
INT	INTERIOR
INV	INVERT
JAN	JANITOR
JT	JOINT
JST	JOIST
LAB	LABORATORY
LAV	LAVATORY
LKRS	LOCKERS
LG	LENGTH
L.W.C	LIGHTWEIGHT CONCRETE
M.P.S	METAL PLASTER STOP
MAS	MASONRY
MACH	MACHINE
MAT'L	MATERIAL
MAX	MAXIMUM
MECH	MECHANICAL
MET	METAL
MIN	MINIMUM
M.T	METAL THRESHOLD
M.O	MASONRY OPENING
MULL	MULLION
M.S	METAL OR MECH SUSPENSION
N.I.C	NOT IN CONTRACT
NO OR #	NUMBER
OBS. GL	OBSCURE GLASS
OBS. W.GL	OBSCURE WIRE GLASS
O.C	ON CENTER
O.C.V	ON CENTER-VERTICALLY
OPNG	OPENING
PARTN	PARTITION
PL	PLATE
PLAS	PLASTER
PPG	POLISHED PLATE GLASS
PTD	PAINTED
P.R.V	PAPER ROOF VENTILATOR
QT	QUARRY TILE
REC	RECESS OR RECESSED
R	RISER
RAD	RADIUS
R.F	ROOF DRAIN
REG	REGISTER
REINF	REINFORCED
RM	ROOM
R.V	ROOF VENT
REC	RECEPTIVE
S.C	STORAGE CABINET
SECT	SECTION
SCHED	SCHEDULE
S.B	STEEL BEAM
SPECS	SPECIFICATIONS
SQ FT	SQUARE FEET
S/S	STAINLESS STEEL
S.S	SERVICE SINK
STL	STEEL
STD	STANDARD
STG	STORAGE
STRUCT	STRUCTURAL
SUSP	SUSPENDED
S.P.T.U	STRUCTURAL PRINK TILE UNITS
S.S.D	SEE STRUCTURAL DRAWINGS
T	TOILET
T.B	TACKBOARD
T.C	TERRA COTTA
T.O.C	TOP OF CURB
T.O.W	TOP OF WALL
T	TREAD
T.J	TOP OF JOISTS
U.R	URINAL
U.L	UNDERWRITERS LABORATORY
U.V	UNIT VENTILATOR
V.A.T.C	VENTILATING ACOUSTICAL TILE CEILING
VENT	VENTILATOR
V.ASB.T	VINYL ASBESTOS TILE
W/SCT	WAINSCOT
W.V	WALL VENT
WD	WOOD
W.W.M	WELDED WIRE MESH
WDW	WINDOW
W.I	WROUGHT IRON
W.C	WATER CLOSET
W.F	WASH FOUNTAIN
Y.D	YARD DRAIN

MATERIAL SYMBOLS

MATERIAL	SYMBOL	MATERIAL	SYMBOL
BRICK		IRON OR STEEL (CROSS SECTION)	
CAST STONE ARCH CONC OR STONE		METAL (ELEVATION)	
CEMENT FILL OR TERRAZZO		MORTAR CEMENT OR PUTTY	
CONCRETE		PLASTER	
CERAMIC OR S.F.T.U.		ROCK	
CONCRETE MASONRY UNITS		WOOD (FINISHED)	
EARTH		WOOD (STRUCTURAL OR BLOCKING)	
GLASS			
GRAVEL			
INSULATION (LOOSE FILL)			
INSULATION (RIGID)			

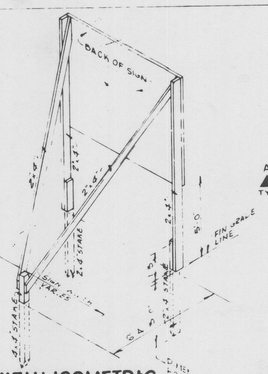

REAR VIEW ISOMETRIC OF TYPICAL SIGN SUPPORT
NO SCALE

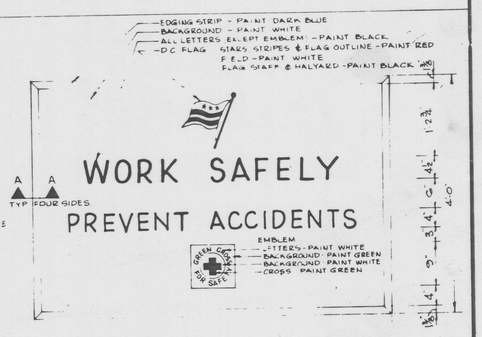

SAFETY SIGN - LAYOUT
SCALE 1"=1'0"

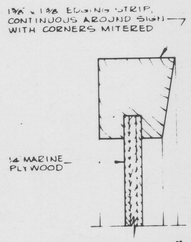

SECTION "A-A"
FULL SIZE

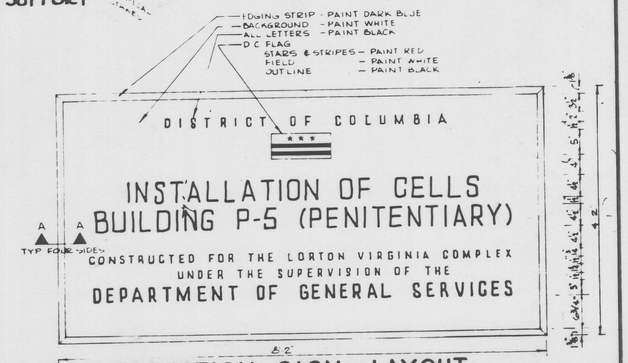

CONSTRUCTION SIGN - LAYOUT
SCALE 1"=1'0" 1"=1'-0"

As Built JUN 1 1973

APPROVED			
DIRECTOR DEPARTMENT OF GENERAL SERVICES DATE 7-29-71	DESIGNED	JUL 1970	ISSUED FOR BID
	DRAWN WAC	REVISION DATE	DESCRIPTION BY APP
	CHECKED		
CERTIFICATION THE PROPOSED MODIFICATIONS TO THIS EXISTING BUILDING ARE DESIGNED IN ACCORDANCE WITH THE DISTRICT OF COLUMBIA BUILDING CODE		PROJECT DRAWINGS	ARCHITECTURAL
		COVER SHEET	DRAWING NO.
		INSTALLATION OF CELLS, BUILDING P-5 LORTON REFORMATORY, LORTON, VIRGINIA D.C DEPARTMENT OF CORRECTIONS	A-1
ASSISTANT DIRECTOR FOR BUREAU OF DESIGN AND ENGINEERING DATE July 22 1970	REGISTRATION NO. A-1128 DATE	NELSON TILGHMAN ASSOCIATES, ARCHITECTS 815 THAYER AVENUE SILVER SPRING, MARYLAND 20910	PROJECT NO. 22-115-78
	ARCHITECT DATE	GOVERNMENT OF THE DISTRICT OF COLUMBIA DEPARTMENT OF GENERAL SERVICES	DATE APRIL 12, 1971
			SHEET 1 OF 10