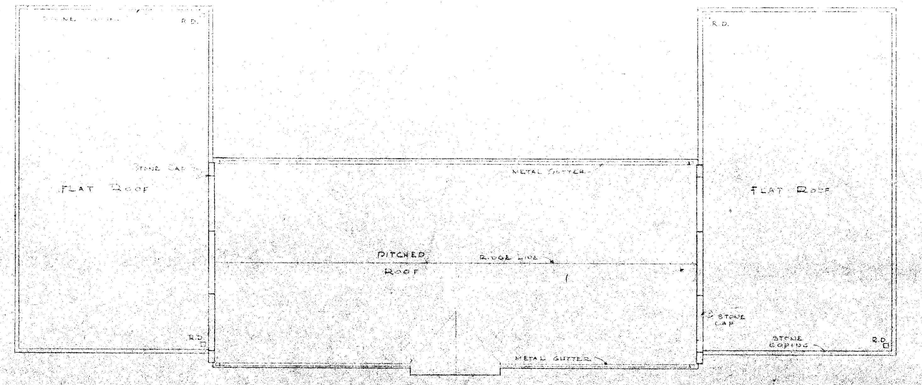

ROOF PLAN

SCALE: 1/16" = 1'-0"

SCHEDULE OF INTERIOR FINISHES

FIN. NO.	FLOOR FIELD	FLOOR BORDER	BASE MAT.	BASE HGT.	WAINSCOT MAT.	WAINSCOT HGT.	WALL	CEILING	REMARKS
1	MARBLE	MARBLE	MARBLE	6"	MARBLE	9'-0"	PLASTER	ACOUSTIC TILE	SEE MAIN ENTRANCE DETAILS
2	ASPH. TILE	—	WOOD		—	—	PLASTER	PAINTED CONCRETE	SEE DETAIL OF WOOD BASE
3	CER. TILE	CER. TILE	CER. TILE	4"	CER. TILE	20 TILES	PLASTER	PLASTER	
4	CONC.	—	METAL	4"	—	—	PLASTER	PLASTER	SEE STAIRWAY DETAILS
5	CEMENT	—	—	—	—	—	BRACK	PLASTER (2 SIDES)	CEILING TO BE PAINTED CONCRETE ON 1ST FLOOR
6	ASPH. TILE	—	WOOD		—	—	PLASTER	PLASTER	SEE WALL SECTIONS
7	ASPH. TILE	—	WOOD		WOOD HAIR BRK.	5'-0"	PLASTER	PLASTER	
8	CER. TILE	CER. TILE	CER. TILE	4"	CER. TILE	13 TILES	PLASTER	PAINTED CONC.	

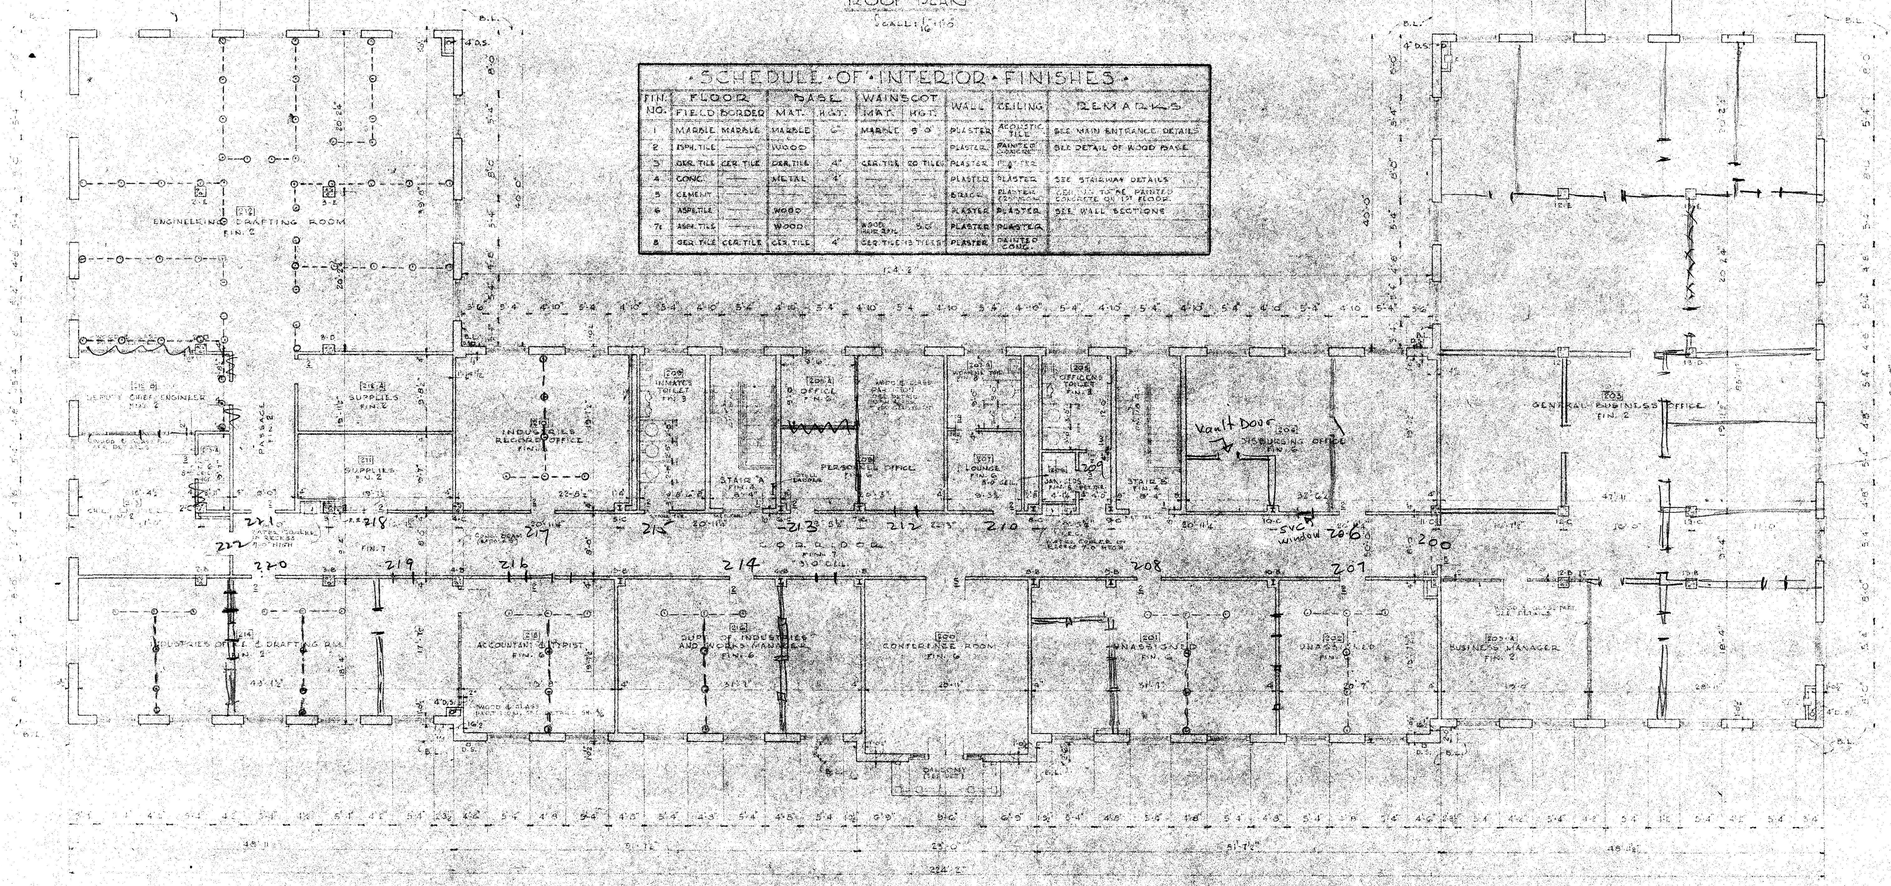

SECOND FLOOR PLAN

SCALE: 1/16" = 1'-0"

Note:
Black pencil mark up indicates present condition.
Red mark up indicates new alterations.

Legend:
Permanent Partition
Office Partition (GSA)

Fol. info given to Mr. Whitaker by phone 28 Jul 80

2nd Floor Gross Area	14,700 SF
(–) approx 20% for hallways, partitions, toilets & svcs	2,900 SF
Net Area	11,800 SF

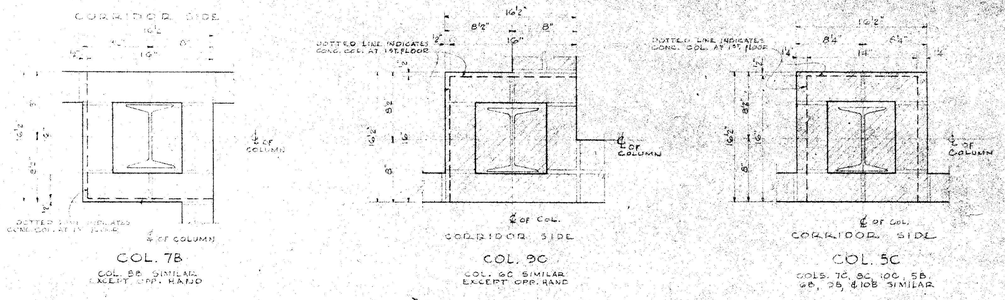

COL. 7B
COL. 8B SIMILAR EXCEPT OPP. HAND

COL. 9C
COL. 6C SIMILAR EXCEPT OPP. HAND

COL. 5C
COLS. 7C, 8C, 10C, 5B, 6B, 9B, & 10B SIMILAR

DETAILS OF BRICK FIREPROOFING AROUND SECOND FLOOR STEEL COLS.

SCALE 1½" = 1'-0"

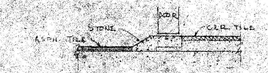

DETAIL - STONE THRESH. "Z"

SCALE 3" = 1'-0"

NOTES:
1. ALL CAT. WALLS & INT. PARTS TO BE SOLID BRICK UNLESS OTHERWISE NOTED.

SECOND FLOOR PLAN

WORK RECORD	NEW CONTROL CENTER	FILE NO.
DRAWN BY	D. C. REFORMATORY	
TRACED BY	LORTON, VIRGINIA	SHEET NO.
CHECKED BY		A/3
DATE	OFFICE OF THE MUNICIPAL ARCHITECT	
SHEET 3 OF 24		