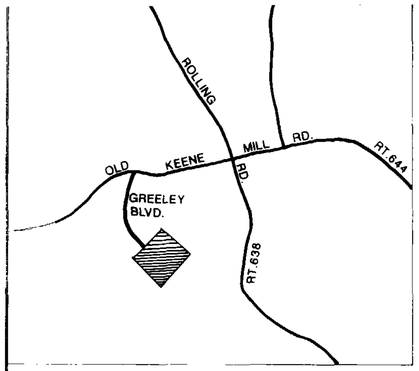

VICINITY MAP

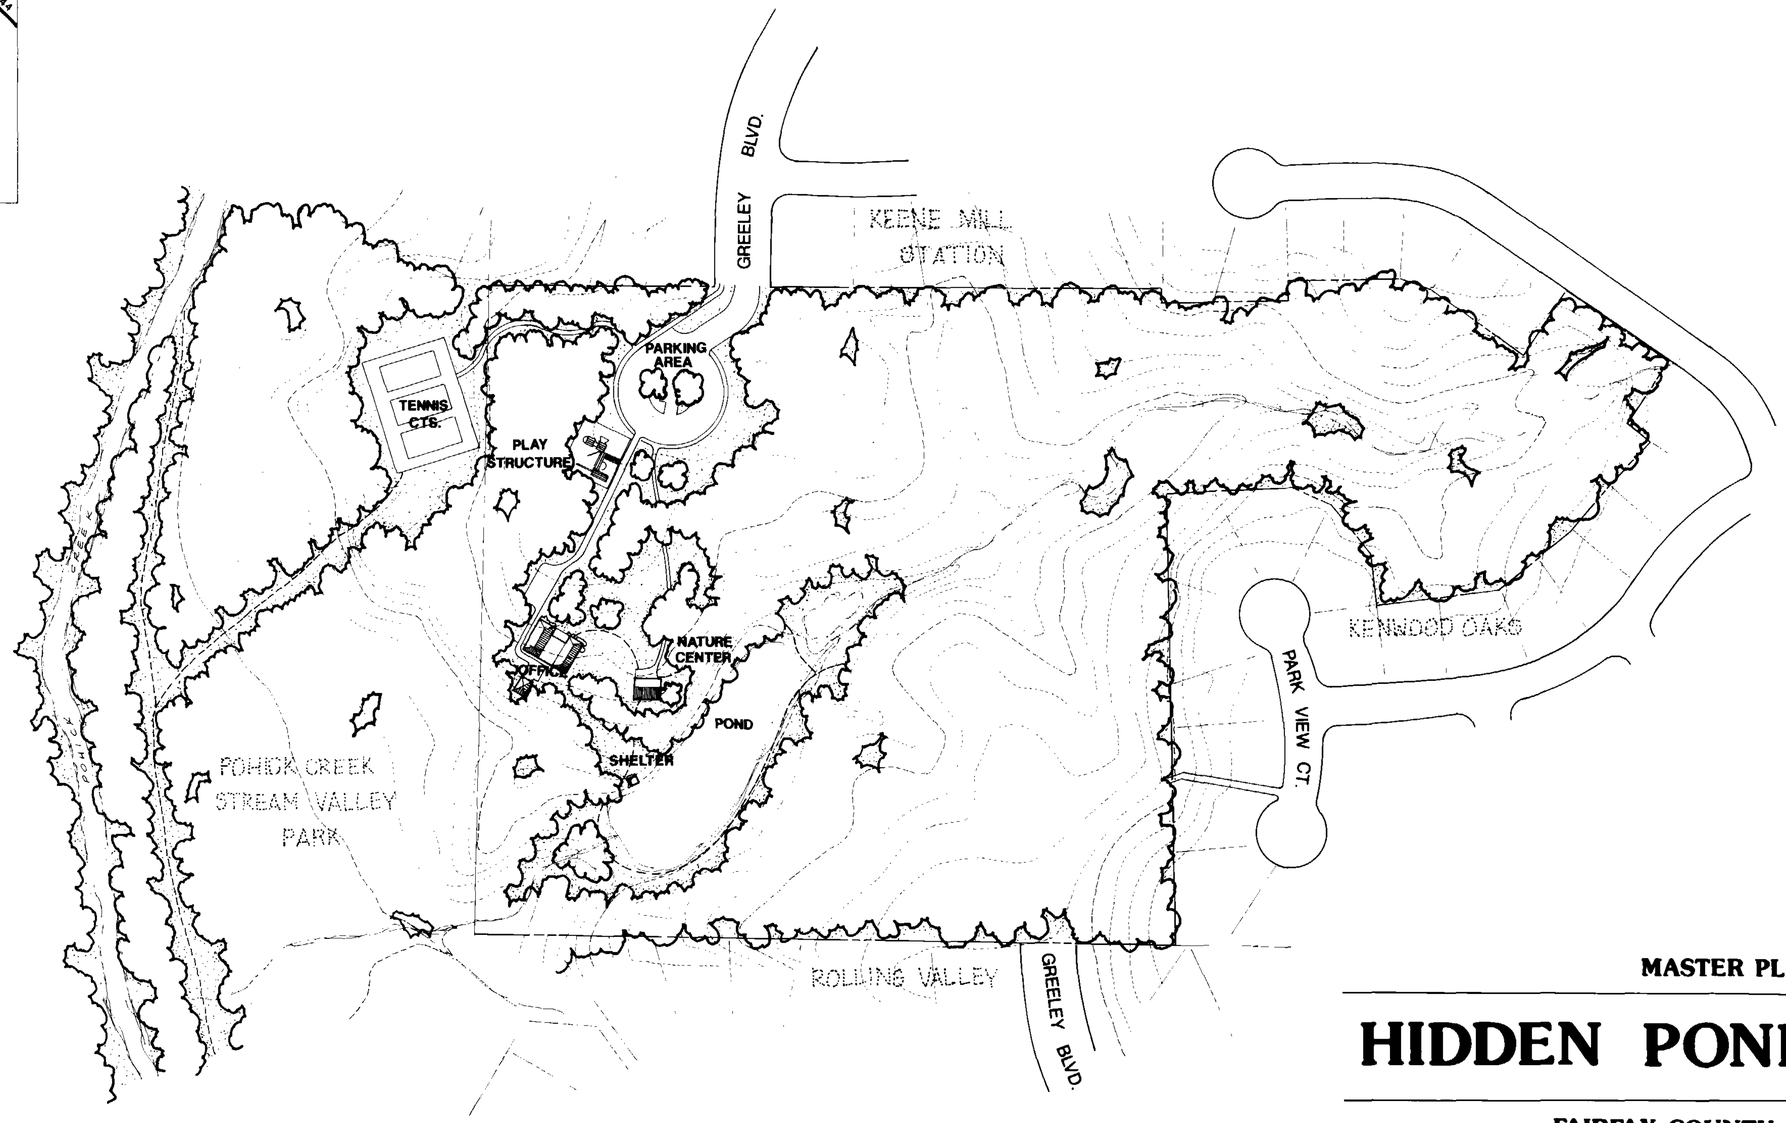

MASTER PLAN

HIDDEN POND PARK

FAIRFAX COUNTY, VIRGINIA

SCALE IN FEET
0 5 10

REVISED AS BUILT JUNE 1997

SCALE: 1"=100' 25.6 AC± TAX MAP 89-1 APPROVED 10/2/74