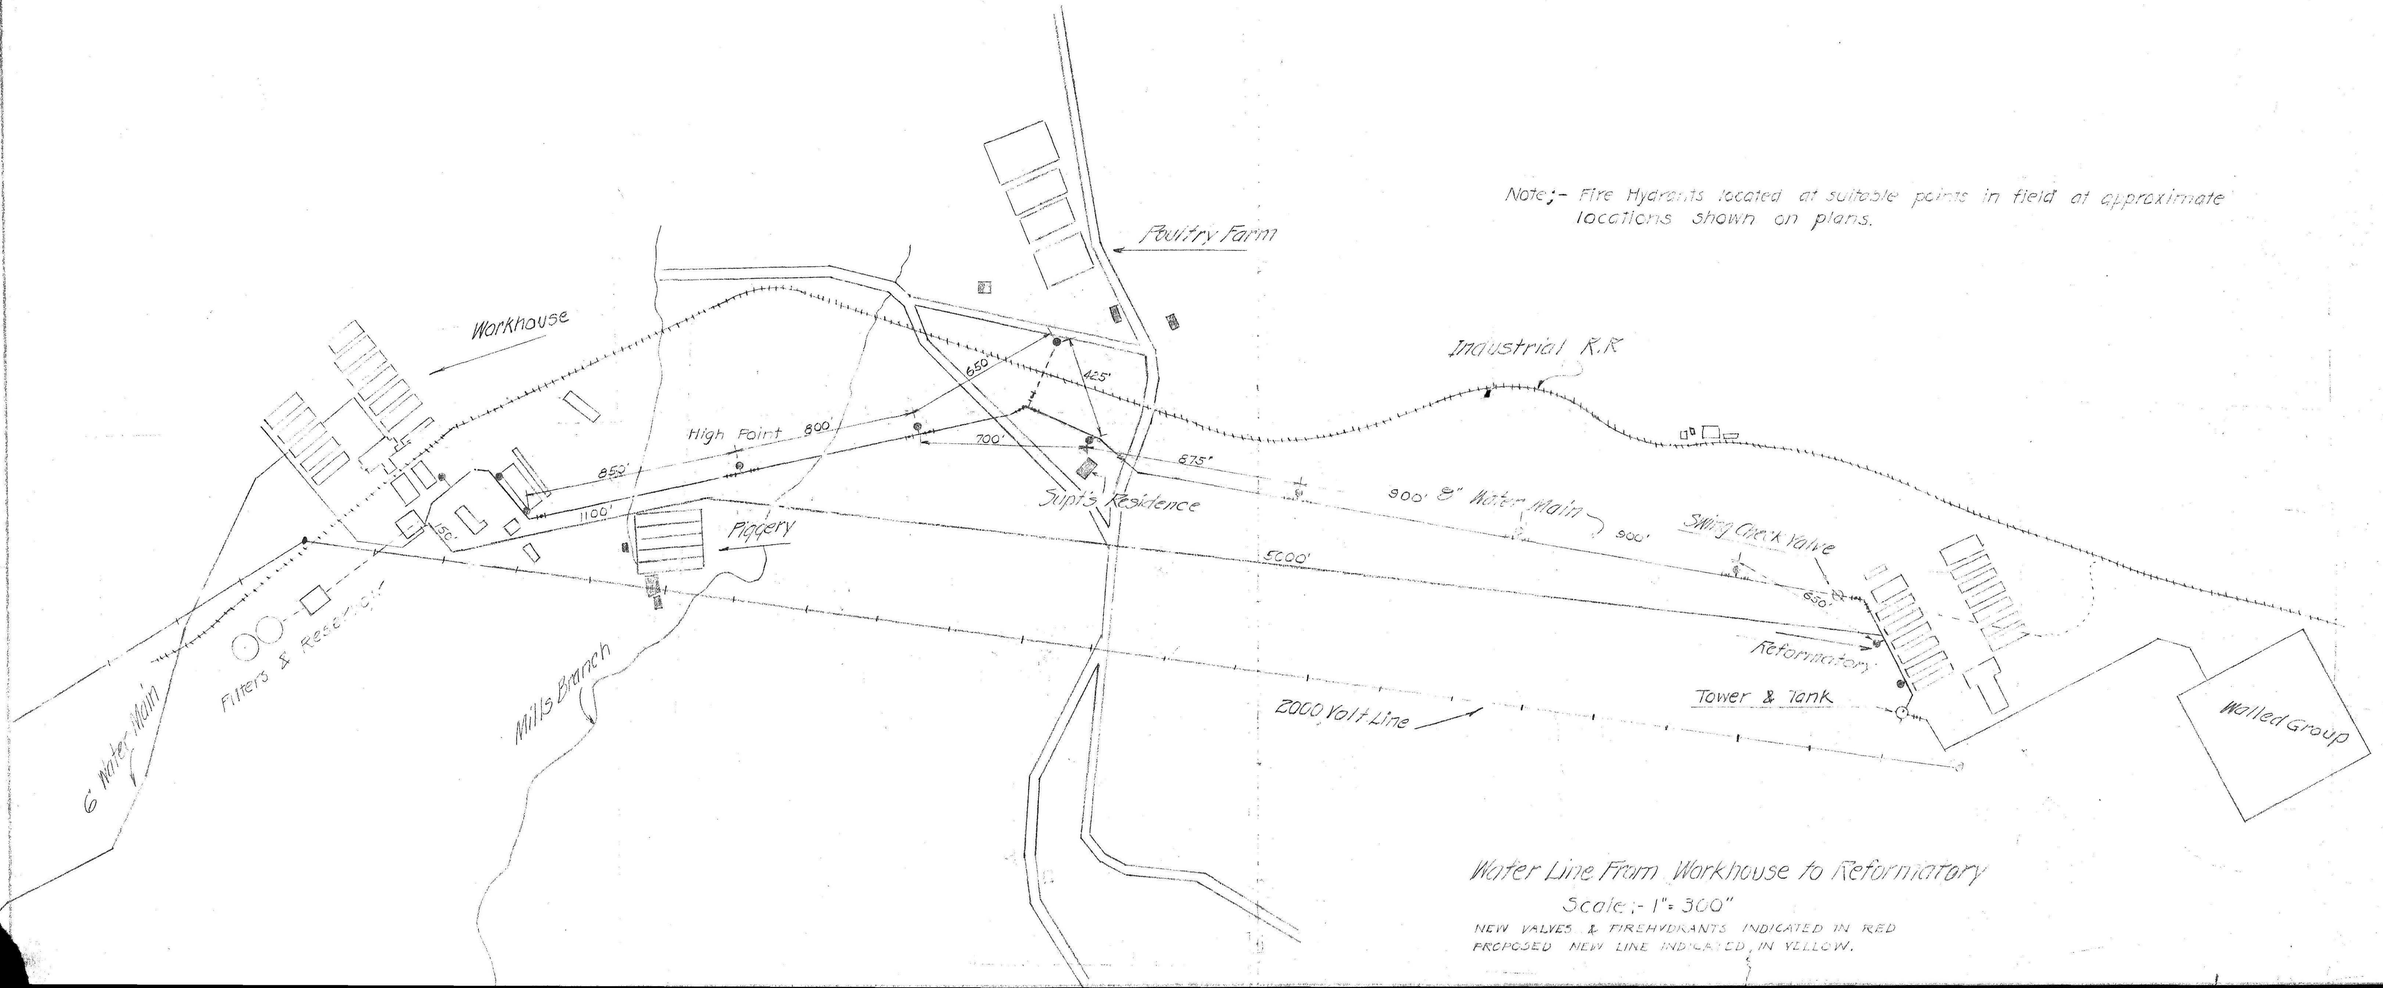

Note;- Fire Hydrants located at suitable points in field at approximate locations shown on plans.

Water Line From Workhouse to Reformatory

Scale;- 1" = 300"

NEW VALVES & FIREHYDRANTS INDICATED IN RED
PROPOSED NEW LINE INDICATED IN YELLOW.